


FLOOR PLAN

SUITE 230:
± 1,577 RSF

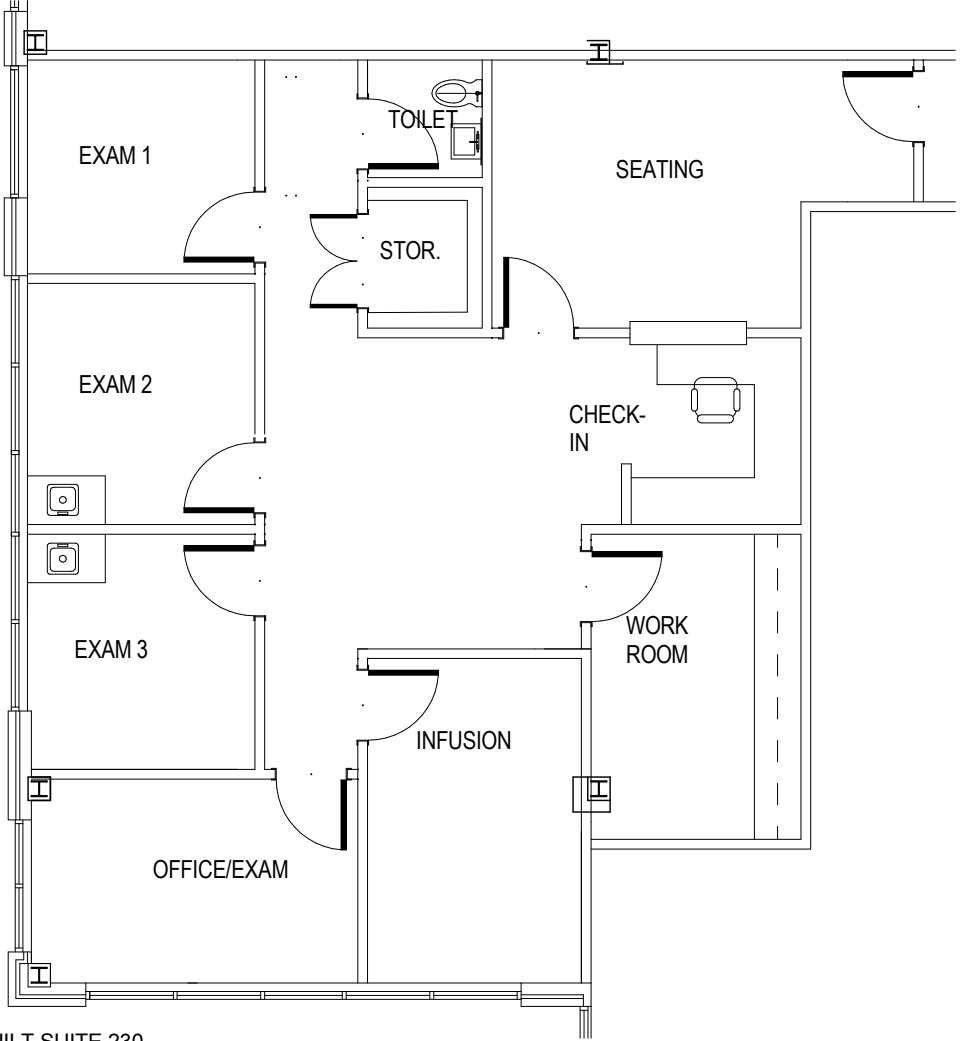

① AS-BUILT SUITE 230
3/16" = 1'-0" ON 11" x 17"